
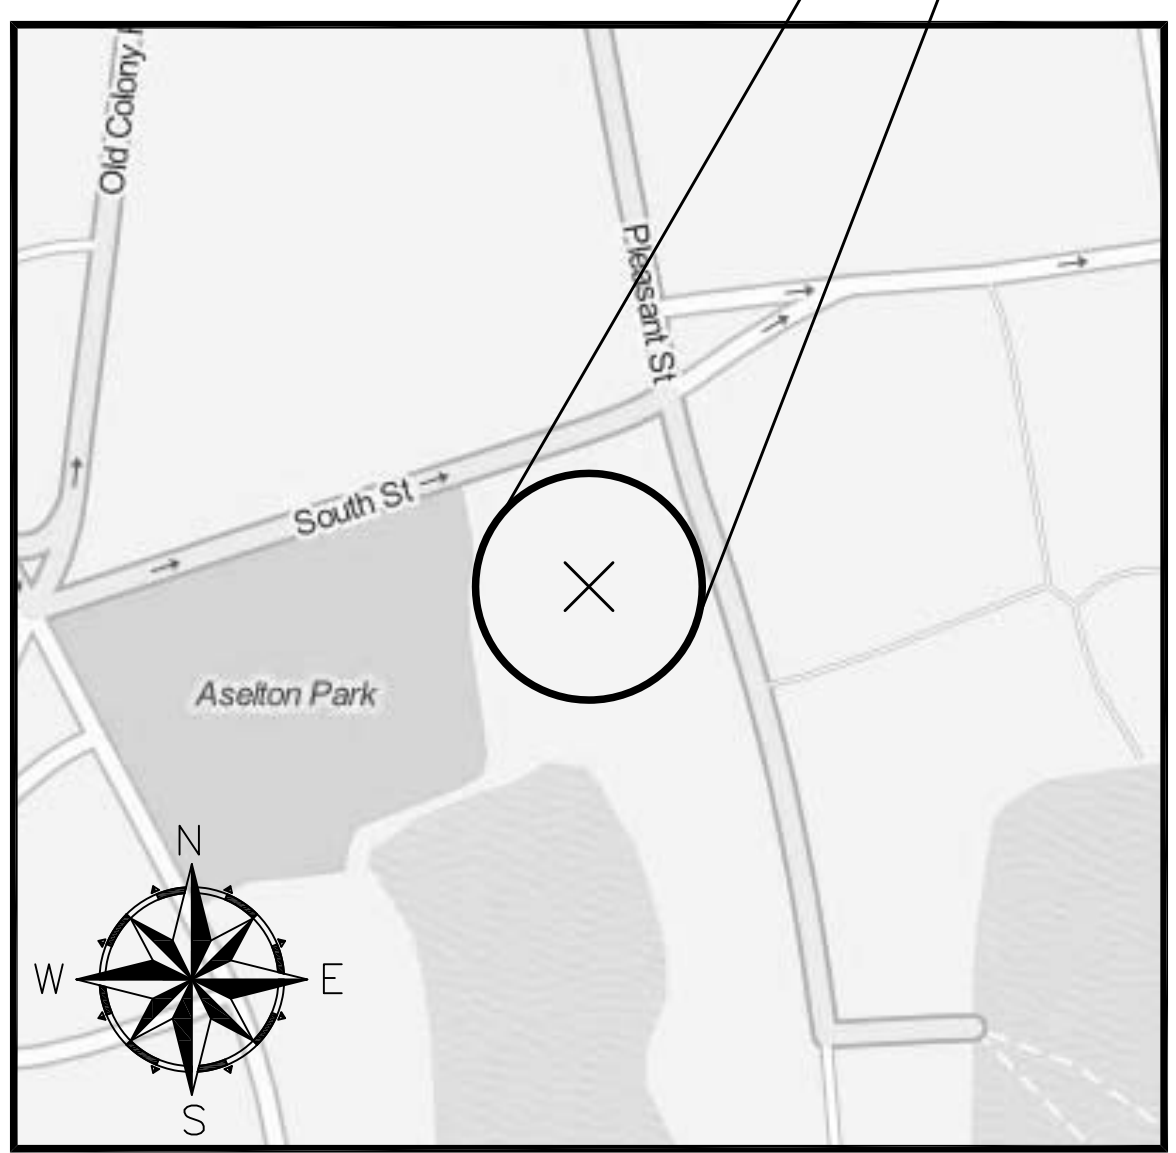


EPA Green Infrastructure Stormwater BMP Retrofit for Two Cape Cod Municipalities A Demonstration and Outreach Project


BARNSTABLE, MA
NOVEMBER 2015 - CONSTRUCTION AS-BUILTS

BARNSTABLE, MA
Gateway Marina BMP - Gravel Bioretention
Cell, South Street & Pleasant Street

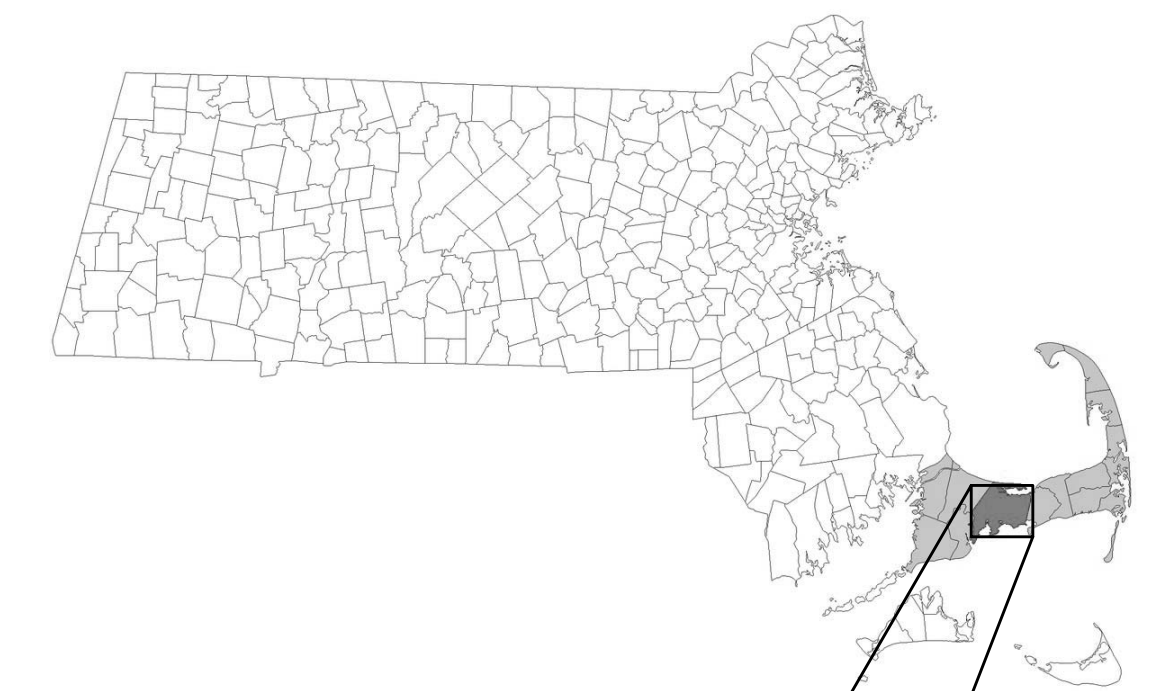

BARNSTABLE PROJECT
SCALE: 1" = 200'

<u>SHEET</u>	<u>TITLE</u>
C-1	EXISTING CONDITIONS
C-2	PROPOSED CONDITIONS
C-3	UTILITY PLAN
C-4	LANDSCAPING AND SURFACE TREATMENTS
C-5	DETAILS
C-6	DETAILS

 **EPA** United States Environmental
Protection Agency, Region 1
5 POST OFFICE SQUARE, SUITE 100
BOSTON, MA 02109

 **WaterVision, LLC**
481 GREAT ROAD, SUITE 3
ACTON, MA 01720

 **COMPREHENSIVE
ENVIRONMENTAL
INCORPORATED**
21 DEPOT STREET
MERRIMACK, NH 03054